

**DEPARTMENT OF COUNTY ENGINEER
DIVISION OF BUILDING AND SAFETY
COUNTY OF LOS ANGELES
WILLIAM J. FOX, COUNTY ENGINEER**

**SEWER—SEWAGE DISPOSAL
PERMIT APPLICATION**

1

FOR APPLICANT TO FILL IN

BUILDING ADDRESS	22410 So Vermont		
LOCALITY	E. Torrance		
NEAREST CROSS ST.	220 + Ocean Ave.		
OWNER	Victor Rosset		
MAIL ADDRESS	22410 So Vermont		
CITY	Torrance	TEL. NO.	
CONTRACTOR	A & M Sewer Const. Co.		
ADDRESS	2017 Redondo Beach Blvd		
CITY	Redondo	TEL. NO.	7521073
REGISTRATION NO.	120312	<input type="checkbox"/> STATE <input checked="" type="checkbox"/> COUNTY	
LEGAL DESCRIPTION	LOT NO.	46	
BLOCK	TRACT	3239	
SIZE OF LOT	330 x 1600	NO. OF BLDGS. NOW ON LOT	3
USE OF BUILDINGS	RES		
NO.	DESCRIPTION OF WORK	FEE	
X	HOUSE SEWER CONNECTING TO PUBLIC SEWER @ \$ 3.50	350	
	HOUSE SEWER CONNECTING TO PRIVATE DISPOSAL SYSTEM 1.00		
X	CONNECT ADDITIONAL BLDG. OR WORK TO HOUSE SEWER 1.00	2.00	
	ALTER OR REPAIR EXISTING SEWER OR DISPOSAL SYSTEM 1.00		
	DISCONNECT AND ABANDON SEWER AND/OR DISPOSAL SYSTEM 1.00		
	SEPTIC TANK, SEEPAGE PIT OR PITS AND/OR DRAINFIELD 2.00		
	CESSPOOL—DRYWELL 2.00		
	SPECIAL CONDITIONS ONLY		

OWNERS AUTHORIZATION	PERMIT	\$ 2.00
	TOTAL FEE	6.50

I HAVE THIS DATE CONTRACTED WITH THE HEREIN NAMED CONTRACTOR TO CONNECT THE ABOVE DESCRIBED EXISTING DWELLING TO THE PUBLIC SEWER

SIGNED THIS 23 DAY OF July 1957

OWNER OR OWNERS AGENT Victor Rosset

ADDRESS _____

I HEREBY ACKNOWLEDGE THAT I HAVE READ THIS APPLICATION AND STATE THAT THE ABOVE IS CORRECT AND AGREE TO COMPLY WITH ALL COUNTY ORDINANCES AND STATE LAWS REGULATING PLUMBING AND SEWERS.

I HEREBY CERTIFY THAT I AM PROPERLY REGISTERED AND/OR LICENSED AS REQUIRED BY LOS ANGELES COUNTY AND STATE OF CALIFORNIA OR THAT I AM THE LEGAL OWNER OF THE ABOVE DESCRIBED RESIDENTIAL PROPERTY.

SIGNATURE OF PERMITTEE James H. Miller

BUILDING ADDRESS	22410 So Vermont		
LOCALITY	Carson		
NEAREST CROSS ST.	223		
DISTRICT NO.	SERIAL NO.	PERMIT NO.	
7-L	44444444	30024-S	
RECEIVED BY	Ready for Inspection	DATE ISSUED	
8/1/57		8/1/57	
USE ZONE	OCCUPANCY	BK	PG
M-3	RES	C	14/6
CO. IMP. NO.	1524		
JOB NO.			
TRUNK PERMIT NO.			
ROAD PERMIT NO.			
STATE ENCROACHMENT PERMIT NO.			
INDUSTRIAL WASTE APPROVAL	Hold for Approval		

CHARGES		
CONNECTION CHARGE FEE		
REIMBURSEMENT FEE		
RECEIPT NO.	DATE	BY
Indust. Waste		
NO.	DATE	BY

CONNECTION DATA		
STATION	14+97.2	DEPTH
		8'-0"
MANHOLE REFERENCE		
UPPER 1-11-N LOWER		
TYPE OF CONNECTION	P.L.	LENGTH FROM M.L. TO P.L.
(Y) CURB		2'-0"

APPROVALS	INSPECTOR'S SIGNATURE	DATE
NEW HOUSE SEWER	J. Bonde	
CONNECT ADDITIONAL BUILDING OR WORK		
SEPTIC TANK, SEEP. PIT(S) AND/OR DRAINFIELD		
CESSPOOL <input type="checkbox"/> DRYWELL <input type="checkbox"/>		
ALTER, REPAIR, SEWER OR SEWAGE DISPOSAL SYSTEM		
DISCONNECT PLUG AND ABANDON HOUSE SEWER		
BACKFILL SEPTIC TANKS <input type="checkbox"/>		
SEEP. PIT(S) <input type="checkbox"/> CESSPOOLS <input type="checkbox"/>	J. Bonde	11/1/57

OVER

FOR DEPARTMENT USE


REQUIRED INFORMATION

1. INDICATE ALL BUILDINGS ON PROPERTY.
2. INDICATE AND DIMENSION SEWAGE DISPOSAL SYSTEM WITH TIE DISTANCES TO BUILDINGS AND PROPERTY LINES.
3. INDICATE SIZE OF SEPTIC TANK—DEPTH OF SEEPAGE PIT(S)—SIZE OF CESSPOOL(S)
4. INDICATE NORTH DIRECTION ON PLOT.
5. INDICATE BOTH STREETS IF CORNER.

$\frac{3.5}{17} = \frac{2.5}{59.5}$
 $\frac{3.5}{17} = \frac{2.5}{59.5}$
 $\frac{3.5}{17} = \frac{2.5}{59.5}$
 $\frac{114}{3} = 38 \text{ yds}$
 $\frac{114}{3} = 38 \text{ yds}$
 $\frac{114}{3} = 38 \text{ yds}$



See ADDIT SAT TOO MANY ITEMS ON THIS

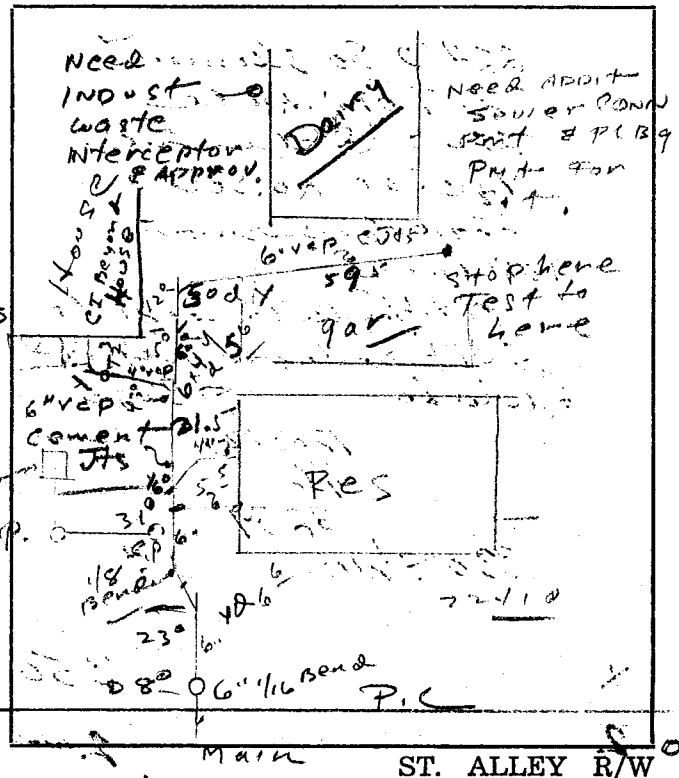

LEGAL DESCRIPTION

VERMONT

FIELD NOTES

CALL FOR INSPECTION ON BACKFILL CESSPOOLS
 OR TO COVER SEWER LINES TO PLACER NOTED
 NEED INDUSTRIAL WASTE APPROX & INTERCEPTOR FOR
 DAIRY, ALSO NEED PLB'S PMT FOR SAND TRAP TO
 DAIRY INSPECT GULF LINE TO DAIRY LATER.
 8/5/54

DEPARTMENT OF COUNTY ENGINEER
DIVISION OF BUILDING AND SAFETY
COUNTY OF LOS ANGELES
WILLIAM J. FOX, COUNTY ENGINEER

SEWER—SEWAGE DISPOSAL
PERMIT APPLICATION

1

FOR APPLICANT TO FILL IN

BUILDING ADDRESS 22410 So Vermont
LOCALITY E-Torrance
NEAREST CROSS ST. 226th St
OWNER Victor Rosset
MAIL ADDRESS Same
CITY _____ TEL. NO. _____
CONTRACTOR A & M. Sewer Cont. Co.
ADDRESS 2017 Redondo Bel Blvd.
CITY Redondo TEL. NO. _____

REGISTRATION NO. 120312 ☐ STATE ☒ COUNTY
LEGAL DESCRIPTION LOT NO. 46
BLOCK _____ TRACT 3239

SIZE OF LOT _____ NO. OF BLDGS. NOW ON LOT 3

USE OF BUILDINGS Dairy Barn

NO.	DESCRIPTION OF WORK	FEE
	HOUSE SEWER CONNECTING TO PUBLIC SEWER @ \$ 3.50	
	HOUSE SEWER CONNECTING TO PRIVATE DISPOSAL SYSTEM	1.00
<input checked="" type="checkbox"/>	CONNECT ADDITIONAL BLDG. OR WORK TO HOUSE SEWER	1.00
	ALTER OR REPAIR EXISTING SEWER OR DISPOSAL SYSTEM	1.00
	DISCONNECT AND ABANDON SEWER AND/OR DISPOSAL SYSTEM	1.00
	SEPTIC TANK, SEEPAGE PIT OR PITS AND/OR DRAINFIELD	2.00
	CESSPOOL—DRYWELL	2.00
	SPECIAL CONDITIONS ONLY	

OWNERS AUTHORIZATION PERMIT \$ 1 00
TOTAL FEE 2 —

I HAVE THIS DATE CONTRACTED WITH THE HEREIN NAMED CONTRACTOR TO CONNECT THE ABOVE DESCRIBED EXISTING DWELLING TO THE PUBLIC SEWER

SIGNED THIS 24 DAY OF Aug 1954

OWNER OR OWNERS AGENT Victor Rosset

ADDRESS _____

I HEREBY ACKNOWLEDGE THAT I HAVE READ THIS APPLICATION AND STATE THAT THE ABOVE IS CORRECT AND AGREE TO COMPLY WITH ALL COUNTY ORDINANCES AND STATE LAWS REGULATING PLUMBING AND SEWERS.

I HEREBY CERTIFY THAT I AM PROPERLY REGISTERED AND/OR LICENSED AS REQUIRED BY LOS ANGELES COUNTY AND STATE OF CALIFORNIA OR THAT I AM THE LEGAL OWNER OF THE ABOVE DESCRIBED RESIDENTIAL PROPERTY.

SIGNATURE OF PERMITTEE John P. Miller

BUILDING ADDRESS 22410 So. Vermont
LOCALITY CARSON
NEAREST CROSS ST. 223rd

DISTRICT NO. 7-L SERIAL NO. A PERMIT NO. 30081 S
RECEIVED BY Benjamin Ready for Inspection DATE ISSUED 9-1-54

USE ZONE M-3 OCCUPANCY DAIRY BARN BK MAP PG C 146

CO. IMP. NO. 1524

JOB NO. _____

TRUNK PERMIT NO. _____

ROAD PERMIT NO. _____

STATE ENCROACHMENT PERMIT NO. _____

INDUSTRIAL WASTE APPROVAL BY ARTHUR PICKETT 8/30/54

CHARGES

CONNECTION CHARGE FEE

REIMBURSEMENT FEE

RECEIPT NO. _____ DATE _____ BY _____

EXCEPTION RECORDED

NO. _____ DATE _____ BY _____

CONNECTION DATA

STATION _____ DEPTH _____

MANHOLE REFERENCE UPPER _____ LOWER _____

TYPE OF CONNECTION CURB _____ P.L. _____ LENGTH FROM M.L. TO P.L. _____

APPROVALS

INSPECTOR'S SIGNATURE _____ DATE _____

NEW HOUSE SEWER

CONNECT ADDITIONAL BUILDING OR WORK

SEPTIC TANK, SEEP. PIT(S) AND/OR DRAINFIELD

CESSPOOL ☐ DRYWELL ☐

ALTER, REPAIR, SEWER OR SEWAGE DISPOSAL SYSTEM

DISCONNECT PLUG AND ABANDON HOUSE SEWER


BACKFILL SEPTIC TANKS ☐

SEEP. PIT(S) ☐ CESSPOOLS ☐

FOR DEPARTMENT USE

REQUIRED INFORMATION

1. INDICATE ALL BUILDINGS ON PROPERTY.
2. INDICATE AND DIMENSION SEWAGE DISPOSAL SYSTEM WITH TIE DISTANCES TO BUILDINGS AND PROPERTY LINES.
3. INDICATE SIZE OF SEPTIC TANK—DEPTH OF SEEPAGE PIT(S)—SIZE OF CESSPOOL(S)
4. INDICATE NORTH DIRECTION ON PLOT.
5. INDICATE BOTH STREETS IF CORNER.

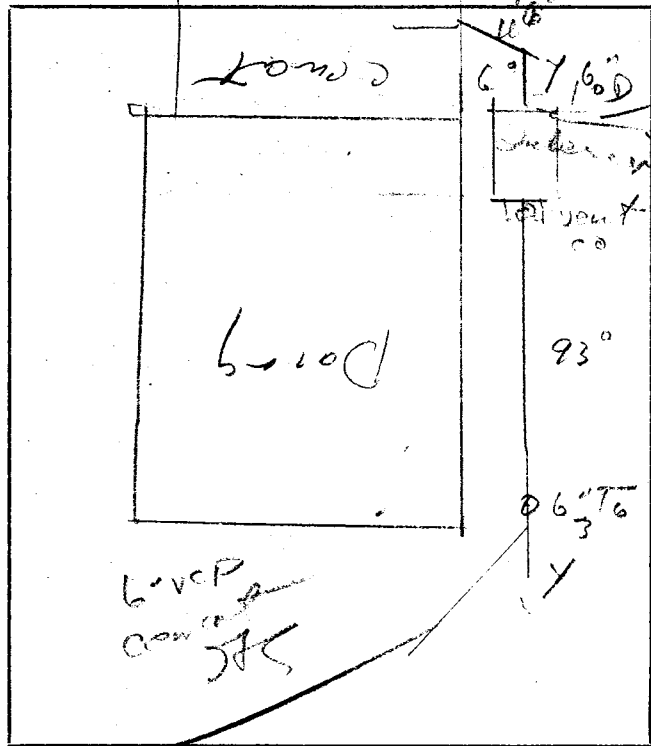

ST. ALLEY R/W

LEGAL DESCRIPTION

FIELD NOTES